


**CABLE ROUTING AND CCTV DESIGN SHOWN MUST BE VERIFIED BY THE CONTRACTOR AND IS FOR INFORMATION ONLY.**

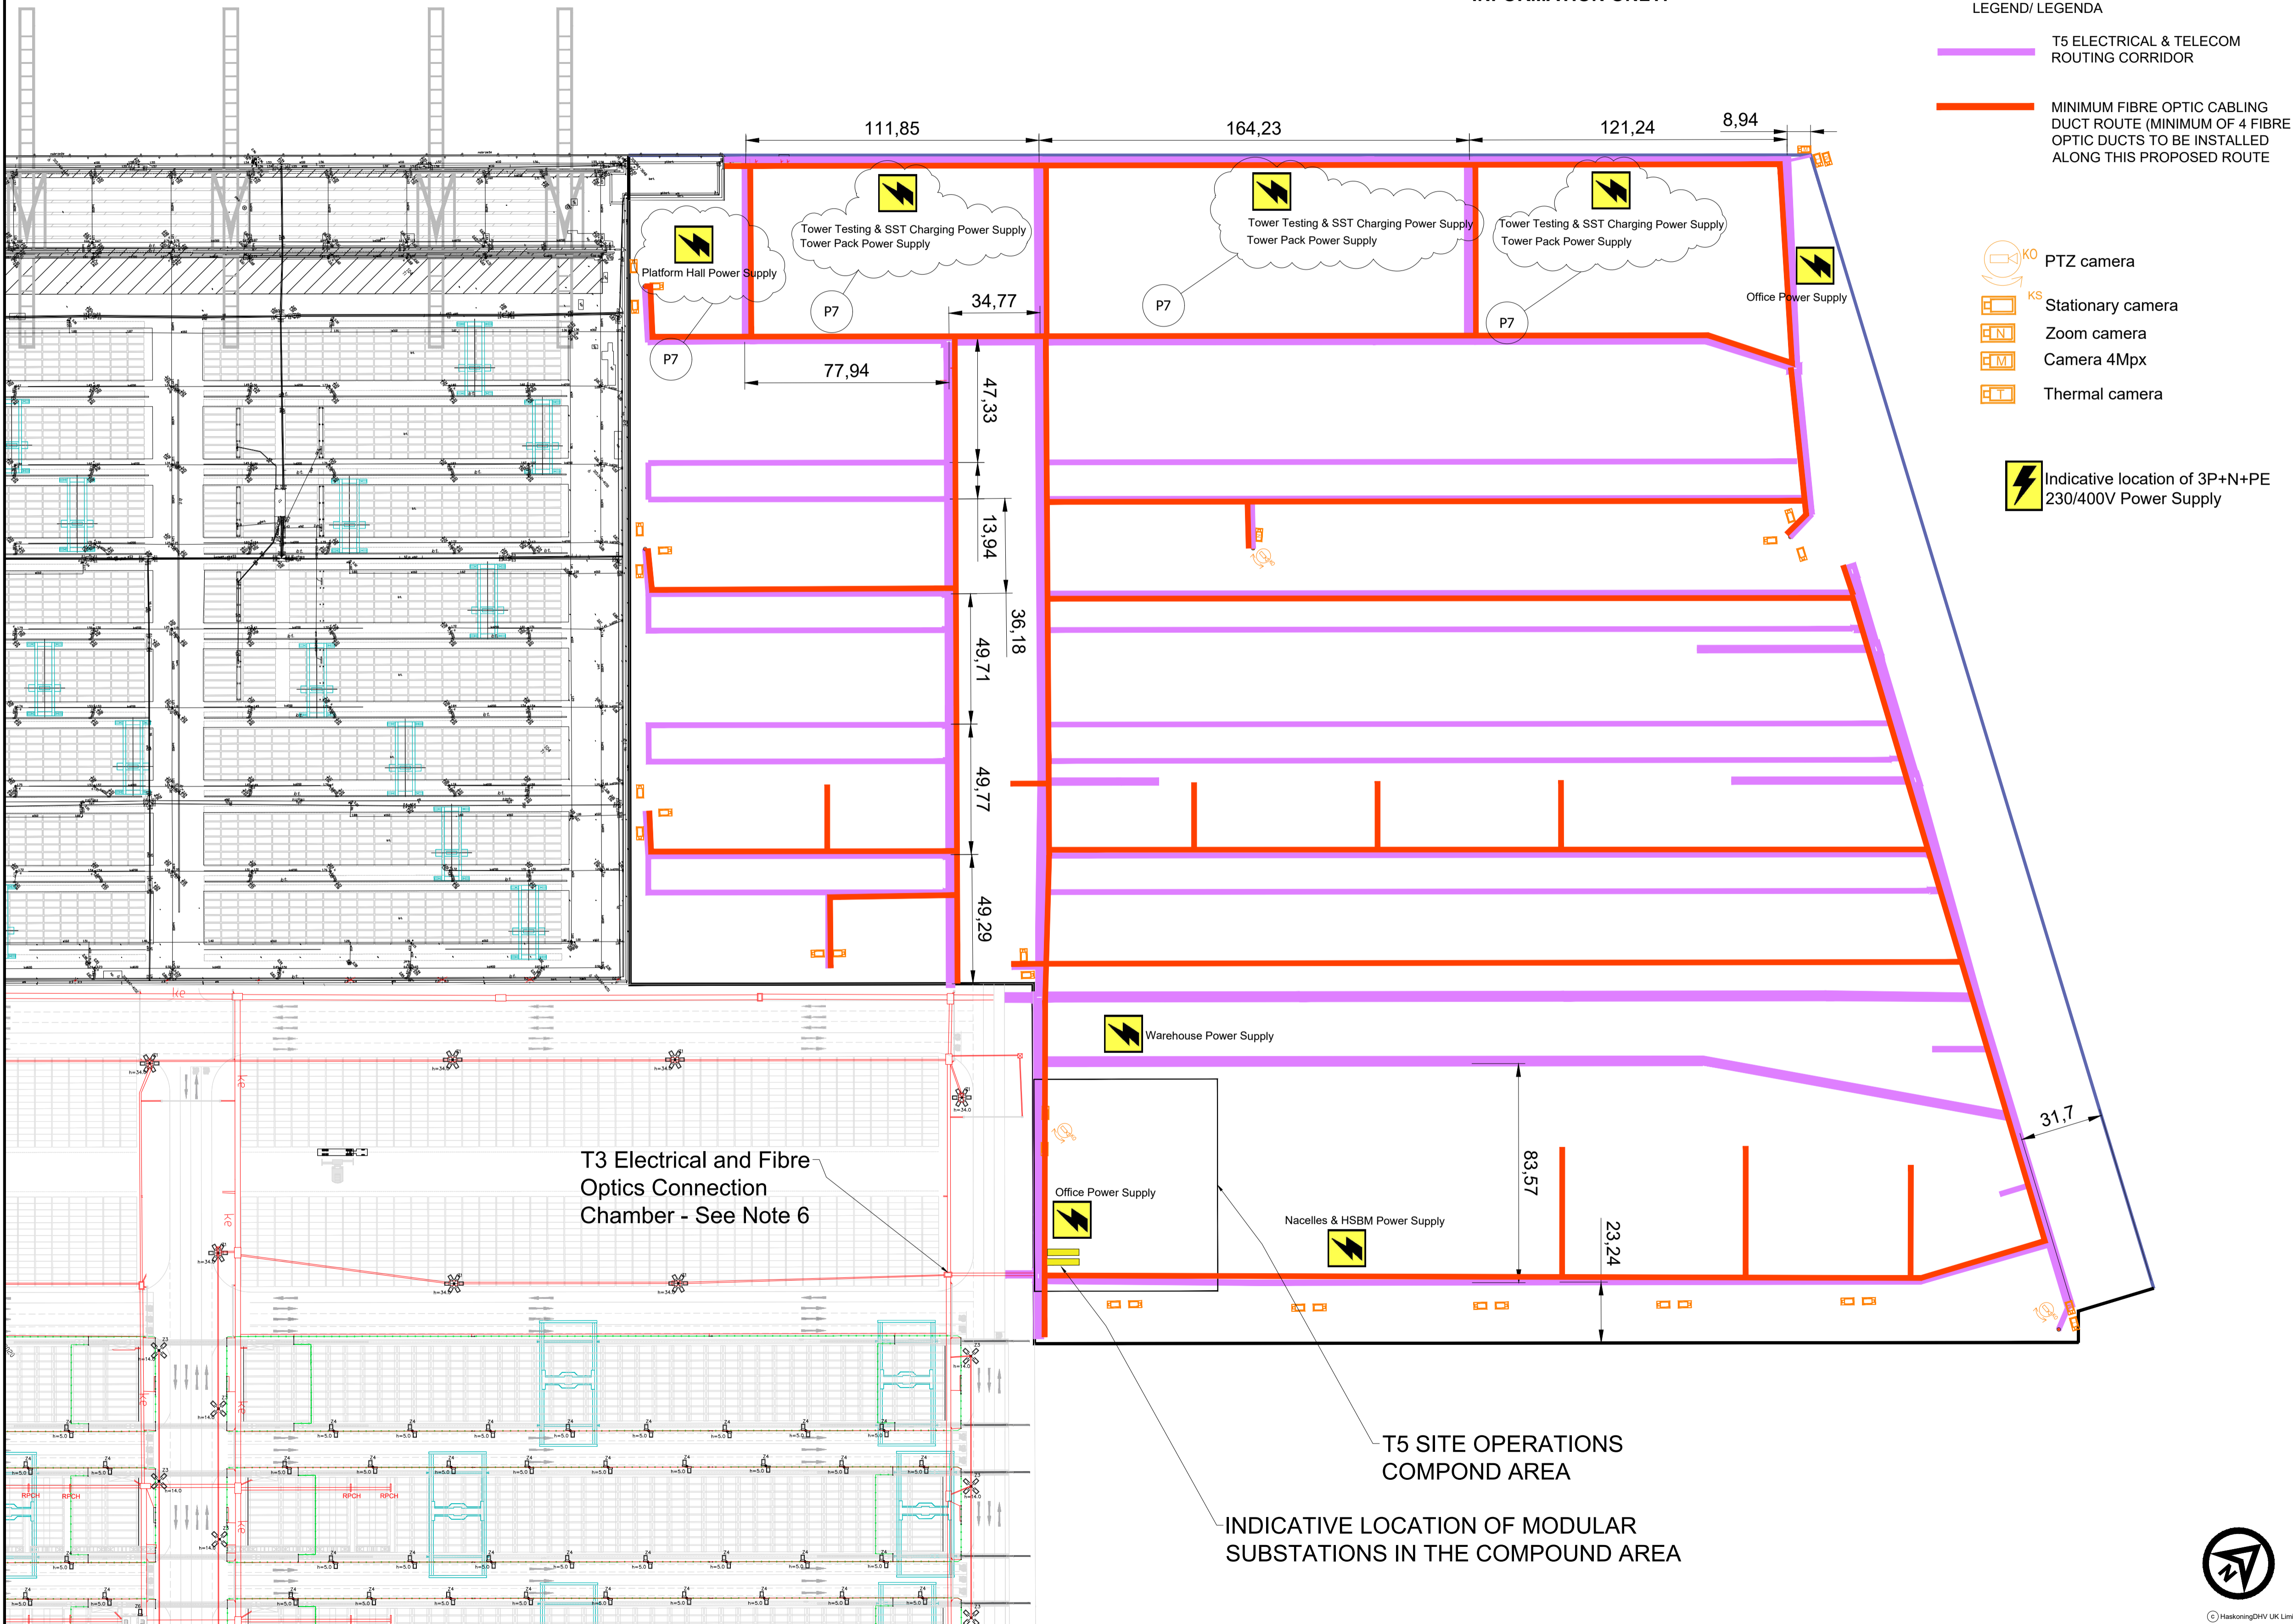

- LEGENDA/ LEGENDA**
- T5 ELECTRICAL & TELECOM ROUTING CORRIDOR
  - MINIMUM FIBRE OPTIC CABLING DUCT ROUTE (MINIMUM OF 4 FIBRE OPTIC DUCTS TO BE INSTALLED ALONG THIS PROPOSED ROUTE)
  - PTZ camera
  - Stationary camera
  - Zoom camera
  - Camera 4Mpx
  - Thermal camera
  - Indicative location of 3P+N+PE 230/400V Power Supply

- NOTES**
1. ALL DIMENSIONS ARE IN METRES, UNLESS NOTED OTHERWISE.
  2. ANY ELEMENTS OR OBJECTS THAT ARE NOT DIMENSIONED SHALL NOT BE SCALED UNDER ANY CIRCUMSTANCES. THEY SHALL BE AGREED/CONFIRMED WITH THE EMPLOYER.
  3. TENDER ISSUE DRAWINGS SHALL BE READ IN CONJUNCTION WITH THE TERMINAL T5 EMPLOYER'S REQUIREMENTS AND RELATED CONTRACT DOCUMENTS
  4. THE CONTRACTOR DOES NOT HAVE TO INSTALL ALL CABLE DUCTS ALONG THE INDICATED SERVICE ROUTING CORRIDORS. CONTRACTOR IS TO ONLY UTILISE THE CORRIDORS DEEMED NECESSARY FOR HIS DESIGN. THE CONTRACTOR MAY DEVIATE FROM THE PROPOSED SERVICE CORRIDORS PROVIDED THAT ALL CLASHES ARE AVOIDED WITH OTHER SERVICES. SHOULD THERE BE ANY DEVIATIONS FROM THE BUILDING PERMIT DESIGN, IT IS THE RESPONSIBILITY OF THE CONTRACTOR TO REPLY FOR THE BUILDING PERMIT.
  5. SERVICE INSPECTION AND CABLE PULLING CHAMBERS SHALL BE LOCATED AWAY FROM ALL TERMINAL ROAD LANES WHERE POSSIBLE WITHIN THE PROPOSED SERVICE CORRIDORS.
  6. THIS IS THE INDICATIVE LOCATION OF THE MAIN ELECTRICAL AND TELECOMMUNICATIONS CABLE CONNECTION FROM TERMINAL T3 AND T5. SPARE DUCTS HAVE BEEN RESERVED IN THE T3 CABLE DUCT BANKS TO ALLOW CONNECTION OF POWER CABLES LEADING FROM THE SUBSTATION ON T3. HOWEVER, CONTRACTOR IS TO CHECK THE EXACT AS BUILT MANHOLE SURVEY ONCE THE T3 WORKS HAS BEEN COMPLETED.
  7. SECURITY CAMERA LOCATIONS ARE INDICATIVE ONLY AND THE CONTRACTOR SHALL CARRY OUT HIS OWN DESIGN AND ASSESSMENT OF CAMERA POSITIONS TO ENSURE ISPS COMPLIANCE.
  8. LOCATION OF THE POWER SUPPLY POINTS SHOWN ARE INDICATIVE ONLY. THE EXACT LOCATION SHALL BE DETERMINED WITH THE ENGINEER

**NOT FOR CONSTRUCTION**

**TENDER**

| REV | DATE     | DESCRIPTION       | BY | CHK | APP |
|-----|----------|-------------------|----|-----|-----|
| P7  | 05/03/24 | TENDER ADDENDUM 3 | AS | AT  | CSJ |
| P6  | 05/03/24 | TENDER ADDENDUM 1 | AS | AT  | CSJ |
| P5  | 06/12/23 | TENDER ISSUE      | AS | AT  | CSJ |
| P4  | 15/11/23 | TENDER ISSUE      | AS | AT  | CSJ |
| P3  | 31/10/23 | TENDER ISSUE      | AS | AT  | CSJ |
| P2  | 27/10/23 | TENDER ISSUE      | AS | AT  | CSJ |
| P1  | 19/09/23 | TENDER ISSUE      | AS | AT  | CSJ |
| P0  | 11/09/23 | TENDER DRAFT      | AS | AT  | CSJ |

**REVISIONS**

CLIENT ISTRANA / Baltic Hub Container Terminal Sp. z o.o.

**Baltic Hub**  
 ISTRANA/ Baltic Hub Container Terminal Sp. z o.o.  
 ul. Kontenerowa 7, 80-601 Gdańsk

**PROJECT**

BALTIC HUB T5 OFFSHORE WIND TERMINAL PROJECT

**TITLE**

ELECTRICAL AND TELECOMS CABLING ROUTES

**Royal HaskoningDHV**  
 Enhancing Society Together

74/2 Commercial Street, Leith, Edinburgh, EH6 6LX  
 Tel: +44(0)131 555 6506  
 Email: info@rhdhv.com  
 Website: www.royalhaskoningdhv.com

| DRAWN       | DD                          | CHECKED     | AT     | APPROVED | CSJ |
|-------------|-----------------------------|-------------|--------|----------|-----|
| DATE        | 17.07.23                    | SCALE       | 1:1000 | REF.     |     |
| DRAWING No. | PC1063-RHD-T5-OW-DR-EL-6001 | SUITABILITY | S4     | REVISION | P07 |



INDICATIVE LOCATION OF MODULAR SUBSTATIONS IN THE COMPOUND AREA

T5 SITE OPERATIONS COMPOUND AREA

T3 Electrical and Fibre Optics Connection Chamber - See Note 6